

**PERFORMANCE
TEST REPORT**

Report No.: A2658.02-401-44

Rendered to:

CORAL ARCHITECTURAL PRODUCTS
Tuscaloosa, Alabama

PRODUCT TYPE: Aluminum Curtain Wall with Transom, Stacked Side-lite and Blanked-out Double Doors

SERIES/MODEL: PW257

Title	Summary of Results
Design Pressure	±80.0 psf
Uniform Load Structural Test Pressure	±120.0 psf

This report contains in its entirety:

- Cover Page:** 1 page
- Report Body:** 10 pages
- Photographs:** 2 pages
- Drawings:** 16 pages
- Sketches:** 1 page

Reference must be made to Report No. A2658.02-401-44, dated 04/21/2011 for complete test specimen description and detailed test results.

1.0 Report Issued To: Coral Architectural Products
3010 Rice Mine Road
Tuscaloosa, Alabama 35406

2.0 Test Laboratory: Architectural Testing, Inc.
2250 Massaro Boulevard
Tampa, Florida 33619
813-628-4300

3.0 Project Summary:

3.1 Product Type: Aluminum Curtain Wall with Transom, Stacked Side-lite and Blanked-out Double Doors

3.2 Series/Model: PW257

3.3 Compliance Statement: Results obtained are tested values and were secured by using the designated test method(s). Test specimen description and results are reported herein.

3.4 Test Dates: 12/09/2010 - 12/10/2010

3.5 Test Location: Architectural Testing, Inc. test facility in Tampa, Florida.

3.6 Test Sample Source: The test specimen was provided by the client. Representative samples of the test specimen will be retained by Architectural Testing for a minimum of four years from the test completion date.

3.7 Drawing Reference: The test specimen drawings have been reviewed by Architectural Testing and are representative of the test specimen reported herein. Test specimen construction was verified by Architectural Testing per the drawings located in Appendix B. Any deviations are documented herein or on the drawings.

3.8 List of Official Observers:

<u>Name</u>	<u>Company</u>
William Smith	Coral Architectural Products
Scott Parker	Architectural Testing, Inc.
Shawn G. Collins, P.E.	Architectural Testing, Inc.

4.0 Test Method(s):

ASTM E 330-02, *Test Method for Structural Performance of Exterior Windows, Curtain Walls and Doors by Uniform Static Air Pressure Difference.*

ASTM E 1886-05, *Standard Test Method for Performance of Exterior Windows, Curtain Walls, Doors and Storm Shutters Impacted by Missile(s) and Exposed to Cyclic Pressure Differentials.*

ASTM E 1996-05, *Standard Specification for Performance of Exterior Windows, Glazed Curtain Walls, Doors and Storm Shutters Impacted by Wind Borne Debris in Hurricanes.*

5.0 Test Specimen Description:

5.1 Product Sizes:

Test Specimen #1:

Overall Area: 14.6 m ² (157.3 ft ²)	Width		Height	
	millimeters	inches	millimeters	inches
Overall size	3835.4	151	3810	150

5.2 Frame Construction:

Frame Member	Material	Description
Head/ Sill	Extruded Aluminum	Drawing #23 (PW 613), #25 (PW652) & #16 (PW203) on sheet 13 of 15
Vertical Mullion	Extruded Aluminum	Drawing #24 (PW650)& #15 (PW202) on sheet 13 of 15
Horizontal Mullion	Extruded Aluminum	Drawing #26 (PW655) & #16 (PW203) on sheet 13 of 15
Jambs	Extruded Aluminum	Drawing #23 (PW613), #24(PW650) & #15 (PW202) on sheet 13 of 15

5.0 Test Specimen Description: (Continued)

5.2 Frame Construction:

	Joinery Type	Detail
All frame corners	Mechanical	The horizontal members were square cut, sealed with silicone and secured with three (3) #14 x 1" hex head screws; through the vertical members into the adjacent horizontal members screw spline.
Threshold to door jamb corners	Mechanical	The threshold was sealed and secured to the door jambs utilizing a threshold clip (#30 on Bill of Materials) with four (4) #12 X 1/2" flat head Phillips screws located two (2) through the threshold into the clip and two (2) through the door jamb into the clip.

5.3 Weatherstripping:

Description	Quantity	Location
Exterior glazing gasket (NG10)	2 rows	Interior side of pressure bars; outer edges.
Exterior perimeter gasket (NG11)	1 row	Interior side of pressure bars at the pocket filler on frame members.
Pressure bar gasket (NG12)	1 row	Interior side of pressure bars; center.
Interior spacer gasket (NG14)	1 row	Exterior side of vertical and horizontal mullions; glazing perimeter.

5.0 Test Specimen Description: (Continued)

5.4 Glazing:

Glass Type	Spacer Type	Interior Lite	Exterior Lite	Glazing Method
1-5/16" IG	Silicone Foam	1/4" heat strengthened -0.090" Sentry Glass Plus®- 1/4" heat strengthened	1/4" heat strengthen	The unit was exterior glazed onto a foam silicone spacer at the perimeter, back bedded with Dow Corning 995 and secured with pressure bar utilizing #12 x 1-1/4" hex washer head self drilling screws located 12" on center.

Location	Quantity	Daylight Opening		Glass Bite
		millimeters	inches	
Transom	1	2190 wide by 1200.2 high	86-1/4" wide by 47-1/4" high	19.1mm (3/4")
Lower side-lite	1	1462.1 wide by 2422.5 high	57-9/16" wide by 95-3/8" high	19.1mm (3/4")
Top side-lite	1	1462.1 wide by 1200.2 high	57-9/16" wide by 47-1/4" high	19.1mm (3/4")

5.5 Drainage:

Drainage Method	Size	Quantity	Location
Weeps	1/4" diameter	1	16" on center of the horizontal pressure bars; above center.
Weeps	1/4" diameter	1	8" from each end and one at the mid-span of the horizontal cover plates; bottom leg.
Mullion caps (SP211)	3"x 2.691"x 0.048"	1	Top and bottom of vertical mullions.
EVA Foam End dam (SP204)	1.287"x 1.787"x 0.745"	1	Each horizontal to vertical connection

5.0 Test Specimen Description: (Continued)

5.6 Hardware:

Description	Quantity	Location
3/8" x 2-1/2" long hexagon flush bolts	1	Top and bottom of active panel lock stile.
1/2" diameter x 4-1/8" long flush bolts.	1	Top and bottom of inactive panel lock stile.
4-3/4" x 4" hinges	3	8-1/2" from top and bottom of hinge stiles and one at the mid-span.

5.7 Reinforcement:

Drawing Number	Location	Material
Detail 317 on Sheet #11	Vertical mullion	4-1/2" wide by 1-7/8" deep by 1/4" thick steel channel with a 4" wide by 3/4" thick flat plate welded inside the channel.

6.0 Installation:

The specimen was installed into a C-10 steel buck. The rough opening allowed for a 1/2" shim space. The interior and exterior perimeter of the unit was sealed with Dow Corning 795.

Location	Anchor Description	Anchor Location
Sill to steel buck	1/2"-13 x 1" hex head bolts	4" and 6" from corner of vertical mullion and 4" from the jamb.
Head to steel buck	1/2"-13 x 2" hex head bolts with washers and nuts.	4" and 6" each side of the vertical mullion, 4" from the jamb corners and one at the mid-span of the transom lite.
Door jamb through frame jamb to steel buck	1/2"-13 x 4-1/2" hex head bolts with washers and nuts.	2", 45-1/2", 50-1/2" and 68" from the bottom corner.
Frame jambs to steel buck	1/2"-13 x 4-1/2" hex head bolts with washers and nuts.	2" up from horizontal to jamb corners.
Door sub-frame jamb to frame jamb and vertical mullion	#12 x 3/4" hex head self drilling screws	4" up from the bottom corners, four (4) at 18" on center and one (1) 2" down from top corners. (Total 12)
Door sub-frame head to horizontal mullion	#12 x 3/4" hex head self drilling screws	4" from each corner and 18" on center. (Total 4)
Threshold to steel buck	#12 x 1-1/4" flat head screws	5-1/2" from each corner and 24" on center. (Total 4)
Vertical mullion to reinforcement	1/4-20 x 3" hex head bolt with washers and nuts.	Through bolted 1" from all horizontal connections.



7.0 Test Results: The temperature during testing was 69°F. The results are tabulated as follows:

7.1 ASTM E 330-02, Structural Performance by Uniform Static Air Pressure Difference.

Test Specimen #1:

Title of Test	Results	Allowed	Note
Uniform Load Deflection, per ASTM E 330 taken at vertical mullion +3828 Pa (-80.0 psf) -3828 Pa (-80.0 psf)	7.6 mm (0.60") max. 18.3 mm (0.72") max	21.1 mm (0.83")max 21.1 mm (0.83") max	1, 2, 3
Uniform Load Deflection, per ASTM E 330 taken at horizontal mullion at transom +3828 Pa (-80.0 psf) -3828 Pa (-80.0 psf)	5.6 mm (0.22") max. 7.11 mm (0.28") max	12.5 mm (0.49") max 12.5 mm (0.49") max	1, 2, 3
Uniform Load Structural, per ASTM E 330 taken at vertical mullion +5742 Pa (+120.0 psf) -5742 Pa (-120.0 psf)	2.3 mm (0.09") max. 1.3 mm (0.05") max	14.7 mm (0.58") max 14.7 mm (0.58") max	1, 2, 3
Uniform Load Structural, per ASTM E 330 taken at horizontal mullion at transom +5742 Pa (+120.0 psf) -5742 Pa (-120.0 psf)	0.5 mm (0.02") max. 0.5 mm (0.02") max	8.6 mm (0.34") max. 8.6 mm (0.34") max	1, 2, 3

7.0 Test Results: (Continued)

7.2 ASTM E 1886, Large Missile Impact

Conditioning Temperature: 14.4°C (58°F)
Missile Weight: 4196 g (9.25 lbs)
Missile Length: 2.4 m (7'11")
Muzzle Distance from Test Specimen: 5.2 m (17'0")

Test Unit #1: Orientation within ±5° of horizontal

Impact #1: Missile Velocity: 15.2 m/s (49.8 fps)	
Impact Area:	Mid-span of horizontal mullion at transom.
Observations:	Missile hit target area, fractured outboard lite and dented aluminum cover cap and pressure plate.
Results:	Pass

Impact #2: Missile Velocity: 15.3 m/s (50.2 fps)	
Impact Area:	Mid-span of vertical mullion.
Observations:	Missile hit target area, dented aluminum cover cap and pressure plate.
Results:	Pass

Note: See Architectural Testing Sketch #1 for impact locations.

7.0 Test Results: (Continued)

7.3 ASTM E 1886, Air Pressure Cycling

Test Unit #1

Design Pressure: ±3840 Pa (±80 psf)

POSITIVE PRESSURE

Pressure Range Pa (psf)	Number of Cycles	Average Cycle Time (seconds)	Maximum Deflection at Indicator mm (inches)					
			#1	#2	#3	#4	#5	#6
766 to 1915 (16 to 40)	3500	1.70	7.87 (0.31)	18.29 (0.72)	12.70 (0.50)	7.11 (0.28)	15.24 (0.60)	18.54 (0.73)
0 to 2298 (0 to 48)	300	6.54	10.92 (0.43)	20.83 (0.82)	14.99 (0.59)	8.13 (0.32)	17.78 (0.70)	21.34 (0.84)
1915 to 3064 (40 to 64)	600	2.07	13.46 (0.53)	25.91 (1.02)	18.03 (0.71)	10.41 (0.41)	22.86 (0.90)	26.16 (1.03)
1149 to 3830 (24 to 80)	100	4.91	16.00 (0.63)	31.24 (1.23)	20.32 (0.80)	12.19 (0.48)	27.69 (1.09)	31.50 (1.24)
			Permanent Set mm (inches)					
			8.64 (0.34)	9.40 (0.37)	12.19 (0.48)	4.32 (0.17)	6.35 (0.25)	9.65 (0.38)

NEGATIVE PRESSURE

Pressure Range Pa (psf)	Number of Cycles	Average Cycle Time (seconds)	Maximum Deflection at Indicator mm (inches)					
			#1	#2	#3	#4	#5	#6
1149 to 3830 (24 to 80)	50	6.20	13.21 (0.52)	30.23 (1.19)	14.73 (0.58)	11.43 (0.45)	26.67 (1.05)	27.69 (1.09)
1915 to 3064 (40 to 64)	1050	2.61	11.18 (0.44)	24.89 (0.98)	12.95 (0.51)	9.40 (0.37)	24.13 (0.95)	24.13 (0.95)
0 to 2298 (0 to 48)	50	6.26	10.16 (0.40)	21.84 (0.86)	12.19 (0.48)	6.86 (0.27)	18.54 (0.73)	18.54 (0.73)
766 to 1915 (16 to 40)	3350	3.12	8.13 (0.32)	19.56 (0.77)	11.43 (0.45)	6.10 (0.24)	15.49 (0.61)	15.75 (0.62)
			Permanent Set mm (inches)					
			1.02 (0.04)	0.51 (0.02)	3.81 (0.15)	0.76 (0.03)	1.78 (0.07)	1.78 (0.07)

Observations: Two (2) #12 x 1-1/4" flat head screws sheared at the threshold; no deglazing was observed.

Result: Pass

Note: See Architectural Testing Sketch #1 for indicator and impact locations.

General Note: All testing was performed in accordance with the referenced standard(s).

Note 1: Loads were held for 30 seconds.

Note 2: Tape and film were used to seal against air leakage during structural testing. In our opinion, the tape and film did not influence the results of the test.

Note 3. Allowable deflections are based on $L/175$

The service life of this report will expire on the stated Test Record Retention End Date, at which time such materials as drawings, data sheets, samples of test specimens, copies of this report, and any other pertinent project documentation, shall be discarded without notice.

If test specimen contains glazing, no conclusions of any kind regarding the adequacy or inadequacy of the glass in any glazed test specimen(s) can be made. This report does not constitute certification of this product nor an opinion or endorsement by this laboratory. It is the exclusive property of the client so named herein and relates only to the specimen(s) tested. This report may not be reproduced, except in full, without the written approval of Architectural Testing, Inc.

For ARCHITECTURAL TESTING, Inc.

John C. McClane
Laboratory Manager

Shawn G. Collins, P.E.
Laboratory Support Engineer

SP:sc/ck

Attachments (pages): This report is complete only when all attachments listed are included.

Appendix-A: Photographs (2)

Appendix-B: Drawings (16)

Appendix-C: Sketches (1)

Appendix A
Photographs



Photo No. 1
Elevation E5
Reinforced Captured Mullion with Series 381 Entrance Door



Photo No. 2
Indicator locations for Elevation E5






Architectural Testing

Test Report No.: A2658.02-401-44
Report Date: 04/21/11
Test Record Retention End Date: 12/10/14

Appendix B Drawings

Corral Architectural Products			
PART NAME	PP257.D1 TEST BUCK	DRAWN	MILL
PART NO.	ELEVATION E5	DATE	3/4/2010
		SCALE	VARIES

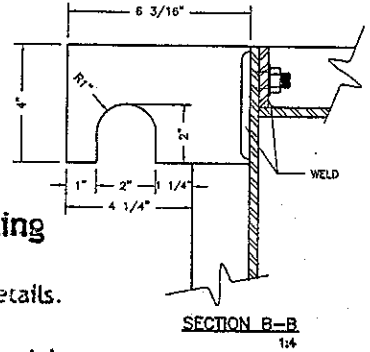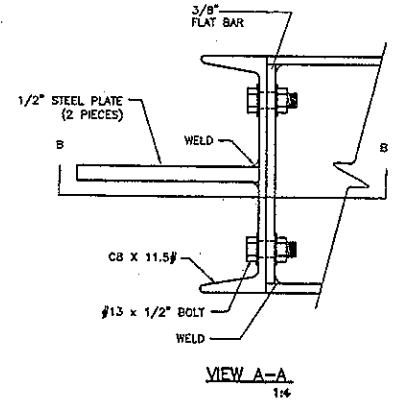
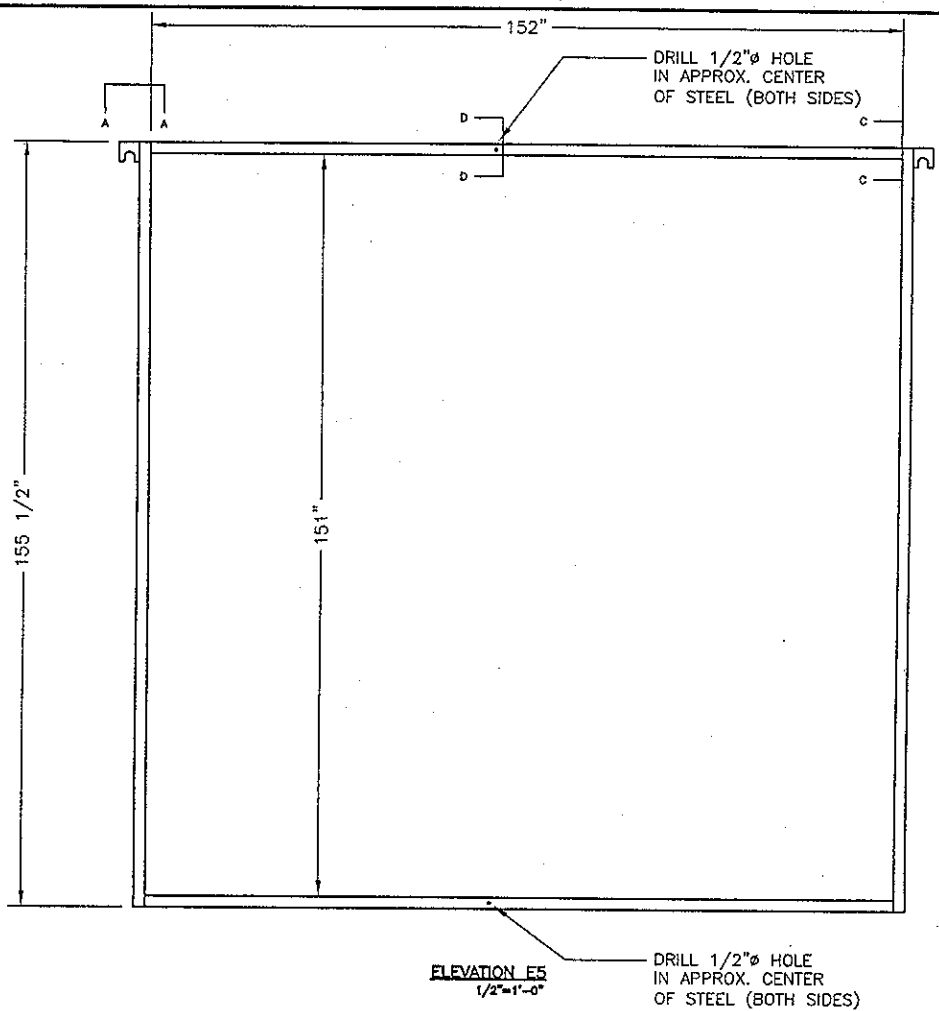


Architectural Testing

Test sample complies with these details.
Deviations are noted.

Report# A2658.02-401-4A

Date 4/19/11 Tech SB

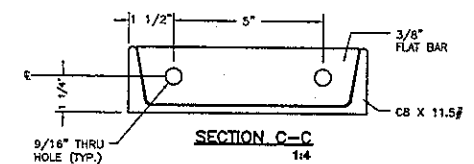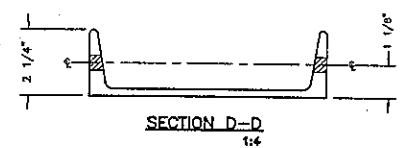

(TOP SHOWN, BOTTOM SIMILAR)

NOTE:
MAKE 1 AS SHOWN

NO	REVISION	BY	DATE

TEST REPORT DRAWINGS PW257 IMPACT-RESISTANT CURTAIN WALL SYSTEM

FOR USE IN HURRICANE ZONES REQUIRING LARGE MISSILE IMPACT PROTECTION

INDEX TO DRAWINGS	
1	INDEX TO DRAWINGS AND NOTES
2	FRAMING ELEVATION - E1 CAPTURED AND B.G. MULLIONS WITH STEEL - LONG SPAN -
3	FRAMING ELEVATION - E2 CAPTURED MULLION WITHOUT STEEL - SHORT SPAN -
4	FRAMING ELEVATION - E3 B.G. MULLION WITHOUT STEEL - SHORT SPAN -
5	FRAMING ELEVATION - E4 CAPTURED MULLION WITH STEEL - LONG SPAN - DRY GLAZE
6	FRAMING ELEVATION FOR DOORS - E5 CAPTURED MULLION WITH STEEL - LONG SPAN -
7	FRAMING DETAILS
8	FRAMING DETAILS
9	FRAMING DETAILS
10	DOOR AND FRAMING DETAILS
11	DOOR AND FRAMING DETAILS
12	FRAMING DETAILS
13	BILL OF MATERIALS
14	BILL OF MATERIALS AND GLAZING SCHEDULE
15	DIE DRAWINGS

ABBREVIATIONS:
D.L.O. = DAY LIGHT OPENING
D.O.H. = DOOR OPENING HEIGHT
D.O.W. = DOOR OPENING WIDTH
ELEVS = ELEVATIONS
EXT. = EXTERIOR
INT. = INTERIOR
MAX. = MAXIMUM
MIN. = MINIMUM
OPP. = OPPOSITE
TYP. = TYPICAL



Architectural Testing
Test sample complies with these details.
Deviations are noted.


Report# A265B.02-401-44
Date 4/19/11 Tech SP

<p style="font-size: small; text-align: center;"> Coral Architectural Products 3616 RICE LANE, ROOM 7108, HOUSTON, TEXAS 77056 PHONE: 800-255-1330 FAX: 800-255-1330 </p>	<p style="writing-mode: vertical-rl; transform: rotate(180deg);"> TEST REPORT DRAWINGS PW257 IMPACT-RESISTANT CURTAIN WALL SYSTEM INDEX TO DRAWINGS AND NOTES </p>						
<p>DATE: 8/24/2010</p> <table border="1" style="width: 100%; border-collapse: collapse;"> <tr> <td style="font-size: x-small;">DRAWN</td> <td style="font-size: x-small;">CHECKED</td> <td style="font-size: x-small;">APPROVED</td> </tr> <tr> <td style="font-size: x-small;">MIL</td> <td style="font-size: x-small;">DCW</td> <td style="font-size: x-small;">DCW</td> </tr> </table> <p>PROJECT NO. TEST DRAWING NO. PW257_01 SHEET 1 OF 15</p>	DRAWN	CHECKED	APPROVED	MIL	DCW	DCW	
DRAWN	CHECKED	APPROVED					
MIL	DCW	DCW					


SPECIMEN #E1	
TEST METHOD	TEST CONDITIONS
AIR INFILTRATION TEST (ASTM E283 AND TAS 203)	1.57 PSF @ 6.24 PSF
WATER INFILTRATION TEST (ASTM E331 AND TAS 203)	20.00 PSF
UNIFORM STATIC LOAD TEST (ASTM E330 AND TAS 202)	+/- 80 PSF DESIGN PRESSURE
LARGE MISSILE IMPACT TEST (ASTM F1886/F1996 AND TAS 201)	9-LB 40Z, 2x4 @ 50FT/SEC
CYCLIC LOAD TEST (ASTM F1996 AND TAS 203)	+/- 80 PSF DESIGN PRESSURE

Architectural Testing
 Test sample complies with these details.
 Deviations are noted.

Report# A2658.02-401-44
 Date 4/19/11 Tech SP

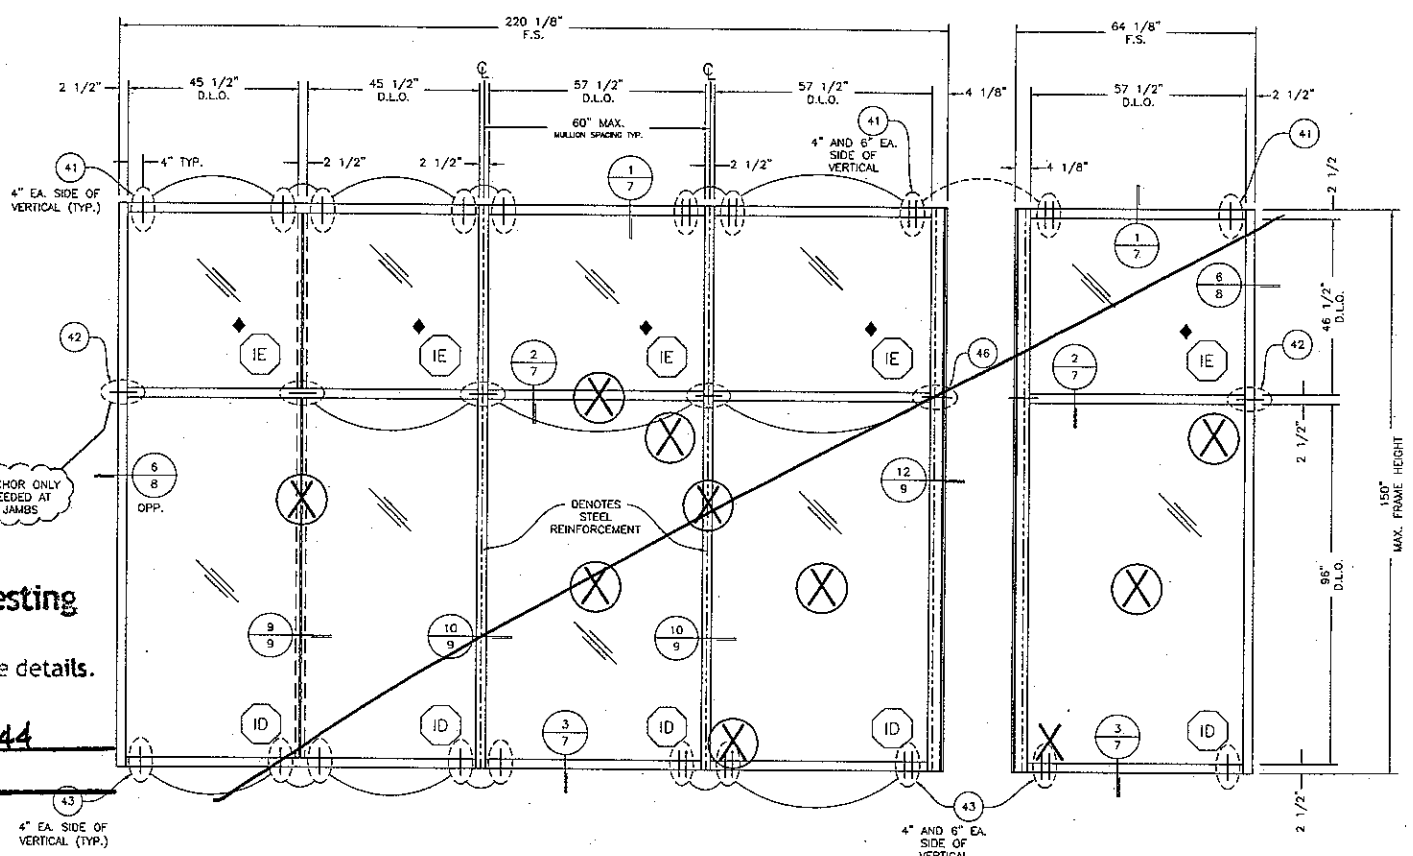

ELEVATION ET
CAPTURED & B.G. MULLIONS -LONG SPAN-
WITH SR150 & 1/2\"x 3-3/4\" BAR
STEEL REINFORCEMENT

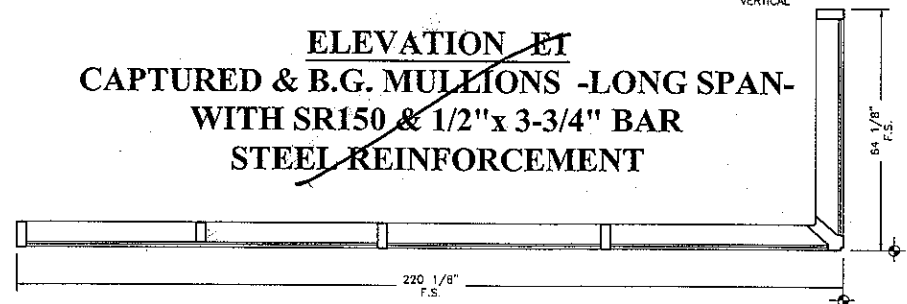


0 1'-4\" 2'-8\" 5'-4\"
 SCALE: 3/8\"=1'-0\"

- (X) = LARGE MISSILE IMPACT LOCATIONS
- ◆ = INFILL ONLY (DO NOT IMPACT)

<p>Coral Architectural Products 3900 W. MIAMI ROAD, SUITE 200, MIAMI, FL 33155 PHONE: 305-757-2737 FAX: 305-455-3530</p>	<table border="1" style="width: 100%; border-collapse: collapse;"> <tr> <th>REV</th> <th>DATE</th> <th>DESCRIPTION</th> </tr> <tr> <td> </td> <td> </td> <td> </td> </tr> <tr> <td> </td> <td> </td> <td> </td> </tr> <tr> <td> </td> <td> </td> <td> </td> </tr> </table>	REV	DATE	DESCRIPTION									
REV	DATE	DESCRIPTION											
<p>TEST REPORT DRAWINGS PW257 IMPACT-RESISTANT CURTAIN WALL SYSTEM</p>													
<p>FRAMING ELEVATION</p>													
<p>DATE: 3/24/2010</p>													
<p>DRAWN: MLL</p>	<p>CHECKED: DCW</p>												
<p>APPROVED: DCW</p>	<p>TEST</p>												
<p>DRAWING NO.: PW257_01</p>													
<p>SHEET 2 OF 15</p>													

SPECIMEN #E2	
TEST METHOD	TEST CONDITIONS
UNIFORM STATIC LOAD TEST (ASTM E330 AND TAS 202)	+/- 65 PSF DESIGN PRESSURE
LARGE MISSILE IMPACT TEST (ASTM E1886/E1996 AND TAS 201)	9-LB 40Z, 2x4 @ 50FT/SEC
CYCLIC LOAD TEST (ASTM E1996 AND TAS 203)	+/- 65 PSF DESIGN PRESSURE

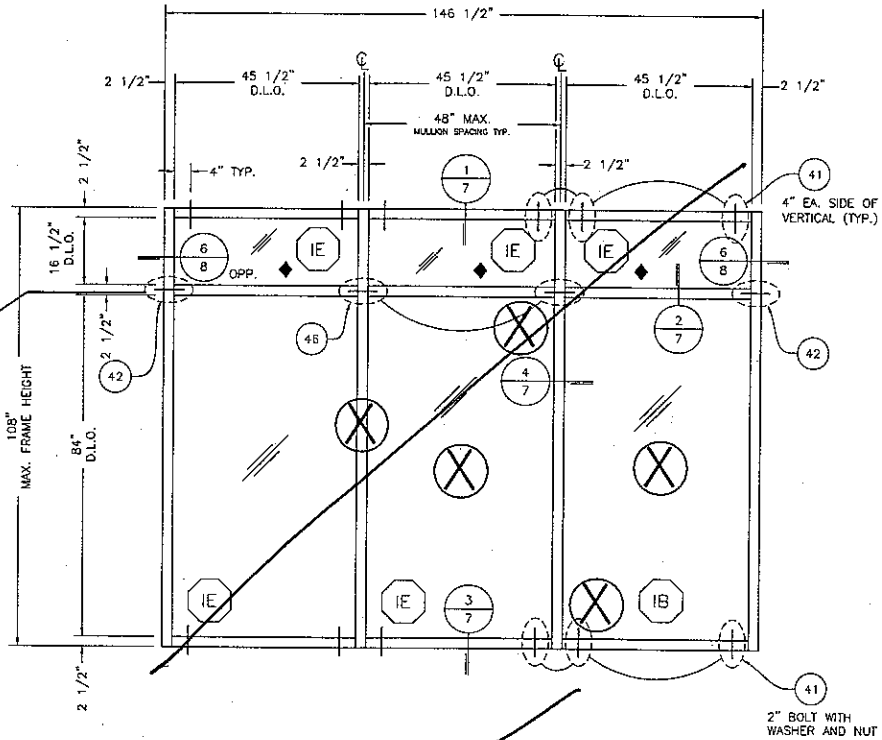

ELEVATION. E2
CAPTURED MULLION -SHORT SPAN-
WITHOUT REINFORCEMENT

STEEL BUCK FRAME

TESTING:
 STATIC, IMPACT, AND CYCLE

MAX. ALLOWABLE DEFLECTION (L/180) = 0.600

DESIGN PRESSURE = +/- 65 PSF

- = LARGE MISSILE IMPACT LOCATIONS
- = INFILL ONLY (DO NOT IMPACT)

0 1'-4" 2'-8" 5'-4"
 SCALE: 3/8" = 1'-0"

REV	BY	DATE	DESCRIPTION

Coral
 Architectural Products
 3700 W. 136th Street, Suite 200
 Overland Park, MO 66207
 Phone: 866.272.7327 Fax: 913.645.1332

TEST REPORT DRAWINGS
 PW257 IMPACT-RESISTANT
 CURTAIN WALL SYSTEM
 FRAMING ELEVATION

DATE	3/24/2010		
DRAWN	CHECKED	APPROVED	
MLL	DCW	DCW	DCW
PROJECT NO.	TEST		
DRAWING NO.	PW257_01		
SHEET	3 OF 15		

SPECIMEN #E3	
TEST METHOD	TEST CONDITIONS
UNIFORM STATIC LOAD TEST (ASTM E330 AND TAS 202)	+/- 65 PSF DESIGN PRESSURE
LARGE MISSILE IMPACT TEST (ASTM F1886/E1996 AND TAS 201)	9-LB 4OZ. 2x4 @ 50FT/SRC
CYCLIC LOAD TEST (ASTM E1996 AND TAS 202)	+/- 65 PSF DESIGN PRESSURE




Architectural Testing

Test sample complies with these details.
Deviations are noted.

Report# A265B.02-401-44

Date 4/19/11 Tech SP

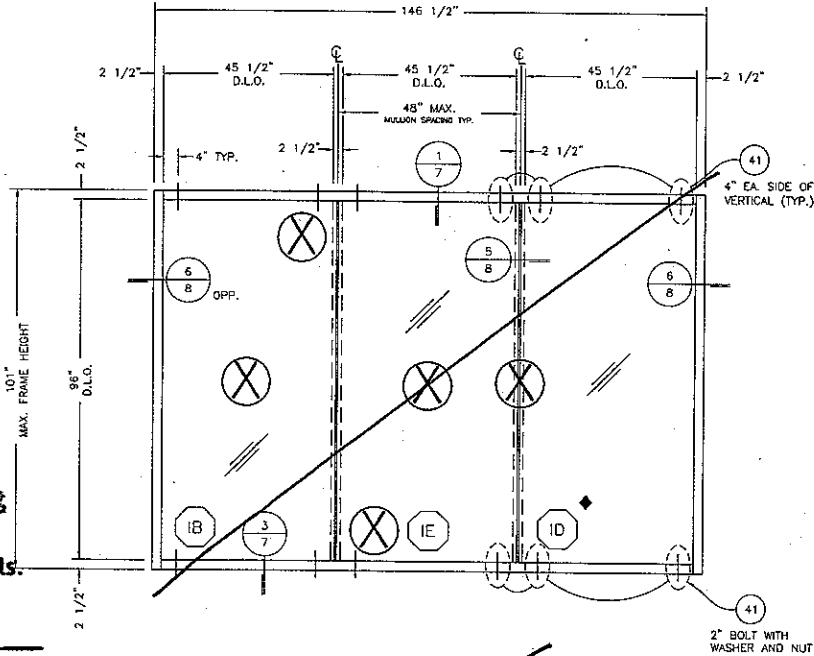

**ELEVATION E3
B.G. MULLION -SHORT SPAN-
WITHOUT REINFORCEMENT**

STEEL BUCK FRAME

TESTING:
STATIC, IMPACT, AND CYCLE

MAX. ALLOWABLE DEFLECTION (L/180) = 0.561

DESIGN PRESSURE = +/- 65 PSF

(X) = LARGE MISSILE IMPACT LOCATIONS

(♦) = INFILL ONLY (DO NOT IMPACT)

0 1'-4" 2'-8" 5'-4"
SCALE: 3/8"=1'-0"


REV	BY	DATE	DESCRIPTION

Coral
Architectural Products
3700 W. BIRCH RD., TUCUMAN, AZ 85684
PHONE: 520-725-7111 FAX: 520-725-7112

TEST REPORT DRAWINGS
PW257 IMPACT-RESISTANT
CURTAIN WALL SYSTEM
FRAMING ELEVATION

DATE	3/24/2010		
DRAWN	CHECKED	APPROVED	
MLL	DCW	DCW	DCW
PROJECT NO.	TEST		
DRAWING NO.	PW257 01		
SHEET	4 OF 15		

SPECIMEN #E1	
TEST METHOD	TEST CONDITIONS
AIR INFILTRATION TEST (ASTM E283 AND TAS 202)	1.57 PSF & 6.24 PSF
WATER INFILTRATION TEST (ASTM E331 AND TAS 202)	20.00 PSF
UNIFORM STATIC LOAD TEST (ASTM E330 AND TAS 202)	+/- 80 PSF DESIGN PRESSURE
LARGE MISSILE IMPACT TEST (ASTM E1886/1996 AND TAS 201)	9-LB 40Z, 2x4 @ 50FT/SEC
CYCLIC LOAD TEST (ASTM E1996 AND TAS 203)	+/- 80 PSF DESIGN PRESSURE

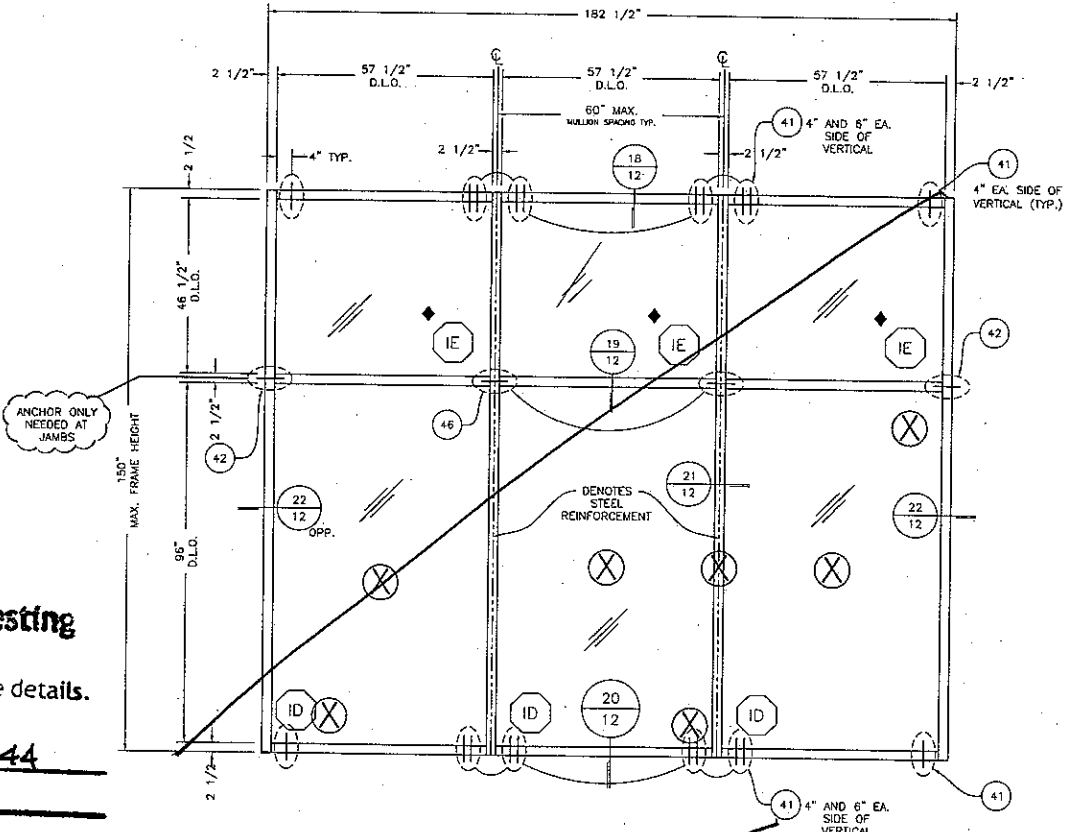

**ELEVATION E4 - DRY GLAZE
CAPTURED MULLION -LONG SPAN-
WITH SR150 & 1/2" X 3-3/4" BAR
STEEL REINFORCEMENT**

STEEL BUCK FRAME


TESTING:
IMPACT, AND CYCLE

MAX. ALLOWABLE DEFLECTION (L/180) = 0.833

DESIGN PRESSURE = +/- 80 PSF

(X) = SMALL MISSILE IMPACT LOCATIONS

(♦) = INFILL ONLY (DO NOT IMPACT)

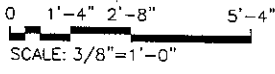

Test sample complies with these details.
Deviations are noted.

Report# A2658.02-401-44

Date 4/19/11 Tech SP


NO.	DESCRIPTION	REV.	BY	DATE

Coral
Architectural Products
300 NICE WINE ROAD, TUSCALOOSA, AL 35468
PHONE: 205/772-7727 FAX: 205-486-6581

TEST REPORT DRAWINGS
PW257 IMPACT-RESISTANT
CURTAIN WALL SYSTEM
FRAMING ELEVATION

DATE	3/24/2010
DRAWN	MLL
CHECKED	DCW
APPROVED	DCW
PROJECT NO.	
DRAWING NO.	PW257_01
SHEET	5 OF 15

SPECIMEN #E5	
TEST METHOD	TEST CONDITIONS
LARGE MISSILE IMPACT TEST (ASTM E1865/E196 AND TAS 201)	9-LB 4OZ, 2x4 @ 50°F/7SEC
CYCLIC LOAD TEST (ASTM E1996 AND TAS 203)	+/- 80 PSF DESIGN PRESSURE

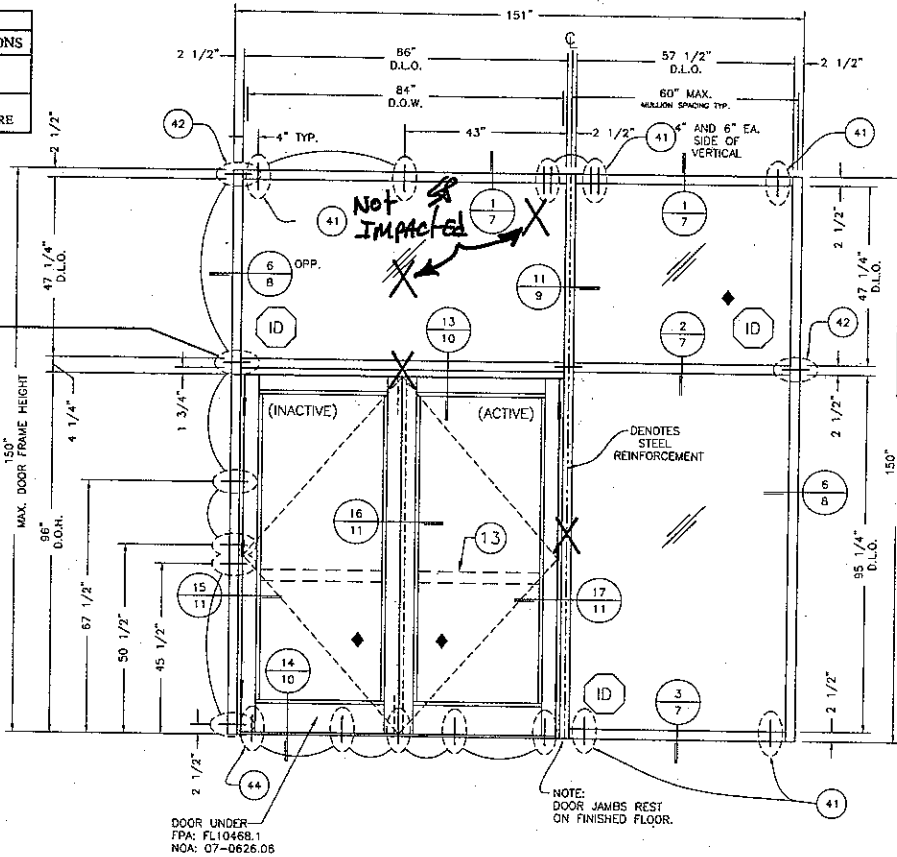

ELEVATION E5
CAPTURED MULLION -LONG SPAN-
WITH SR150 & 3/4" x 3-3/4" BAR STEEL REINFORCEMENT
FOR SERIES 381 ENTRANCE DOORS

STEEL BUCK FRAME

TESTING:
IMPACT, AND CYCLE

MAX. ALLOWABLE DEFLECTION (L/180) = 0.833

DESIGN PRESSURE = +/- 80 PSF

X = LARGE MISSILE IMPACT LOCATIONS

◆ = INFILL ONLY (DO NOT IMPACT)


0 1'-4" 2'-8" 5'-4"
SCALE: 3/8" = 1'-0"



Test sample complies with these details.
Deviations are noted.

Report# A2658.02-401-94

Date 4/19/11 Tech SP

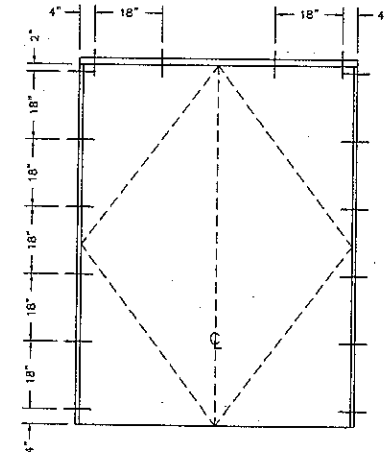

LOCATIONS FOR
DOOR SUB-FRAME ATTACHMENT
TO CURTAIN WALL ALUMINUM


REV	BY	DATE	DESCRIPTION

Coral
 Architectural Products
 3500 BIRCHMOUNT, MUSCATONIA, MO 64576
 PHONE: 816-339-3373 FAX: 816-339-3320


TEST REPORT DRAWINGS
 PW257 IMPACT-RESISTANT
 CURTAIN WALL SYSTEM

FRAMING ELEVATION FOR DOORS


DATE	3/24/2010		
DRAWN	CHECKED	APPROVED	
MILL	DCW	DCW	
PROJECT NO.	TEST		
DRAWING NO.	PW257_01		
SHEET	6 OF 15		

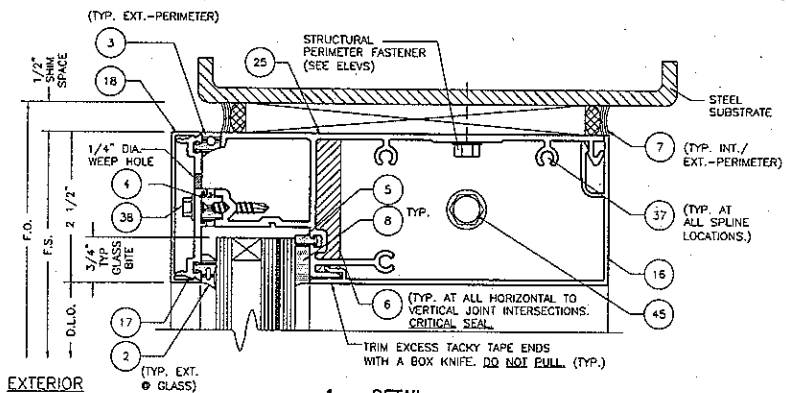


1 - DETAIL
1:2

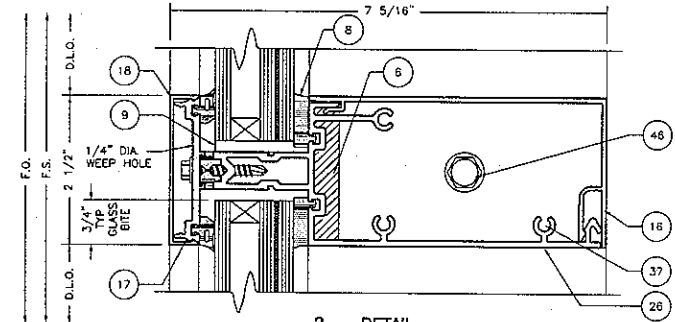

2 - DETAIL
1:2

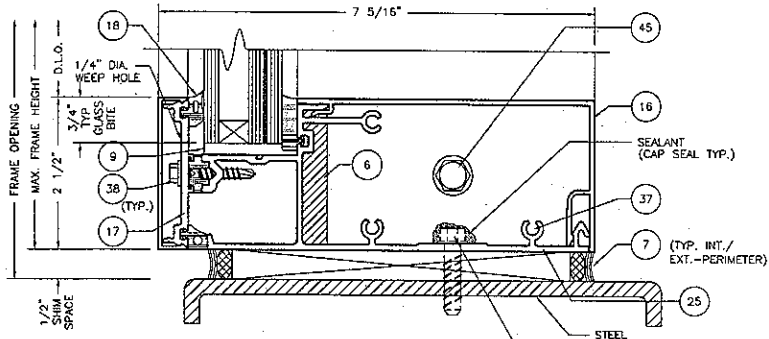


3 - DETAIL
1:2

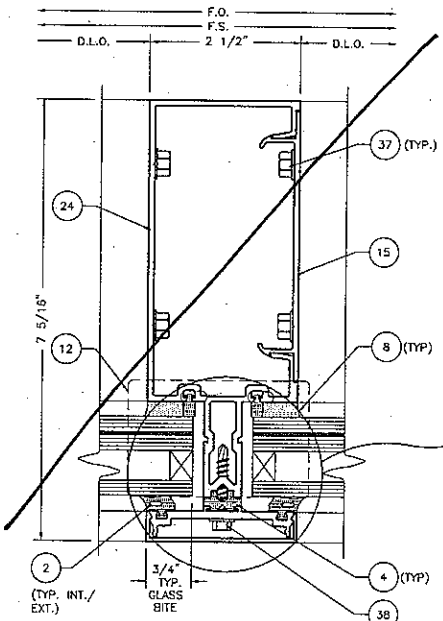

4 - DETAIL
1:2

7 SEAL CONTACT SURFACE W/ DOW 795 BEFORE INSTALLING TOP AND BOTTOM CLOSURE CAP

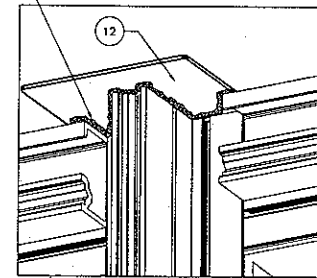

TOP SHOWN CLOSURE CAP (BOTTOM SIMILAR)



Architectural Testing

Test sample complies with these details.
Deviations are noted.

Report# A2658.02-401-44



Date 4/19/11 Tech SP

NO.	DESCRIPTION	DATE	BY	REV

Coral
Architectural Products
801 SEE AMERSON, LUSACORSA, AL 3446
PHONE: 850/723-7337 FAX: 850/743-6281

TEST REPORT DRAWINGS
PW257 IMPACT-RESISTANT
CURTAIN WALL SYSTEM
FRAMING DETAILS




DATE	8/24/2010		
DRAWN	CHECKED	APPROVED	
MLL	DCW	DCW	
PROJECT NO.			
DRAWING NO.	PW257_01		
SHEET	7 OF 15		

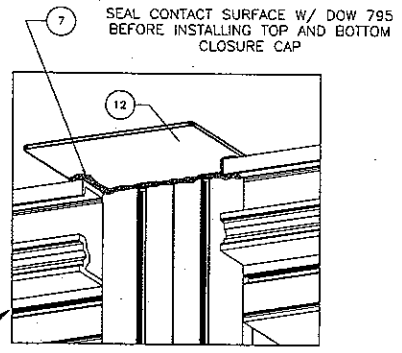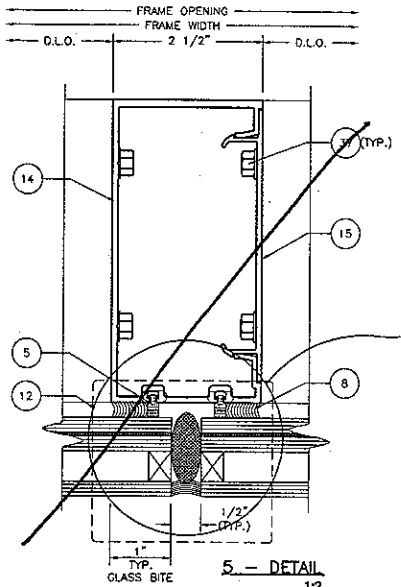

TOP SHOWN CLOSURE CAP (BOTTOM SIMILAR)

7 CRITICAL SEAL
FILL GASKET REGLET BEHIND END DAM W/ DOW 795

7 CRITICAL SEAL
APPLY DOW 795 SEALANT TO ALL THREE CONTACT SURFACES PRIOR TO INSTALLATION AT HORIZONTALS AND SILL.

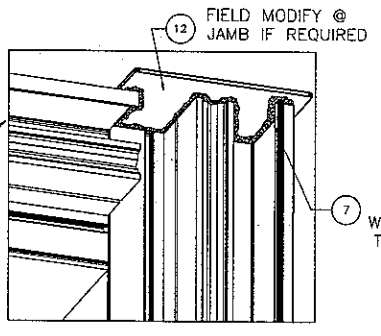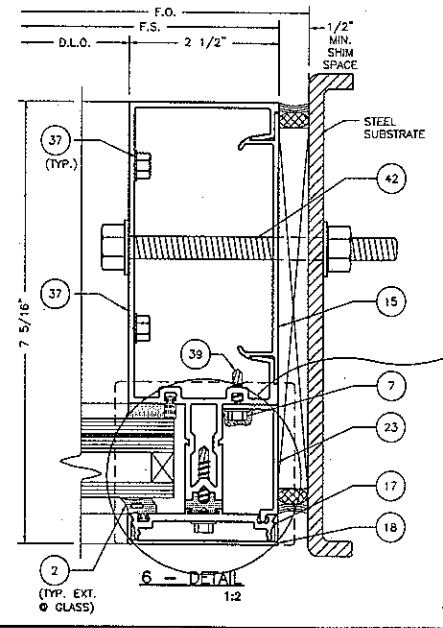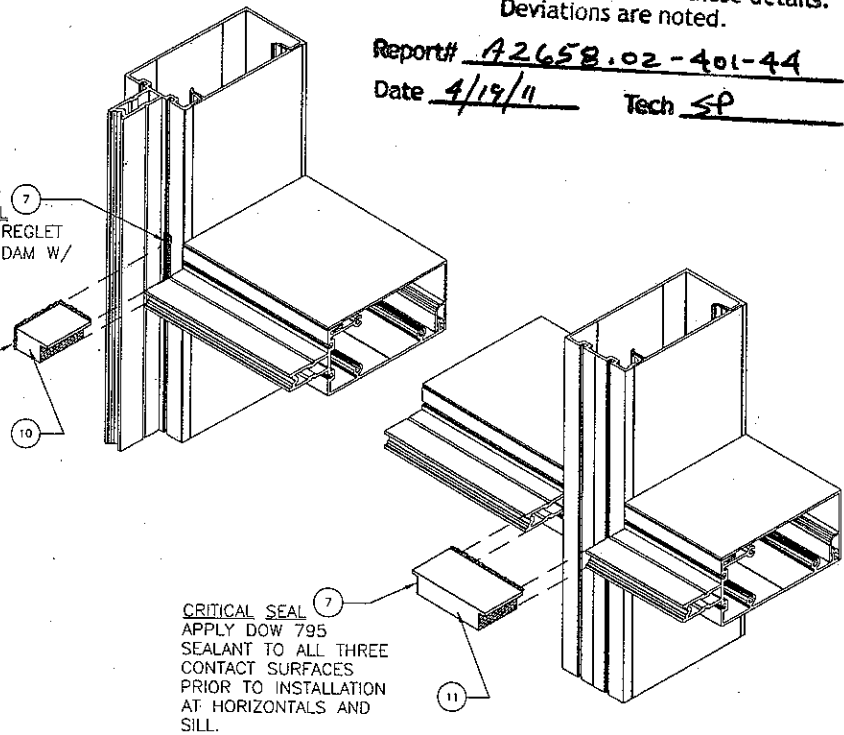

TOP SHOWN CLOSURE CAP (BOTTOM SIMILAR)


7 SEAL CONTACT SURFACE W/ DOW 795 BEFORE INSTALLING TOP AND BOTTOM CLOSURE CAP

Architectural Testing


Test sample complies with these details.
Deviations are noted.

Report# A2658.02-401-44
Date 4/19/11 Tech SP


DESCRIPTION	
REV	DATE
Conal Architectural Products 3010 BUCHHEIMER ROAD, TUCUMAN, CA 95296 PHONE: 909-722-7277 FAX: 909-449-6201	
TEST REPORT DRAWINGS PW257 IMPACT-RESISTANT CURTAIN WALL SYSTEM FRAMING DETAILS	
DATE	8/24/2010
DRAWN	ALL
CHECKED	DCW
APPROVED	DCW
PROJECT NO.	
DRAWING NO.	PW257_01
SHEET	8 OF 15

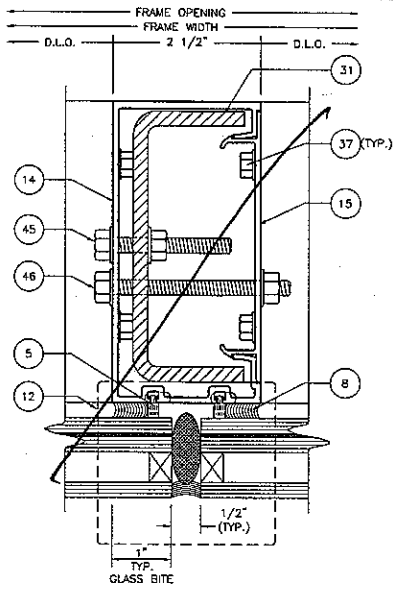


7 - DETAIL
1:2

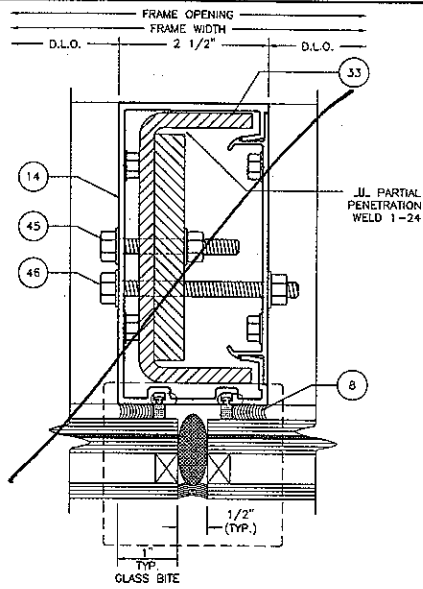


9 - DETAIL
1:2

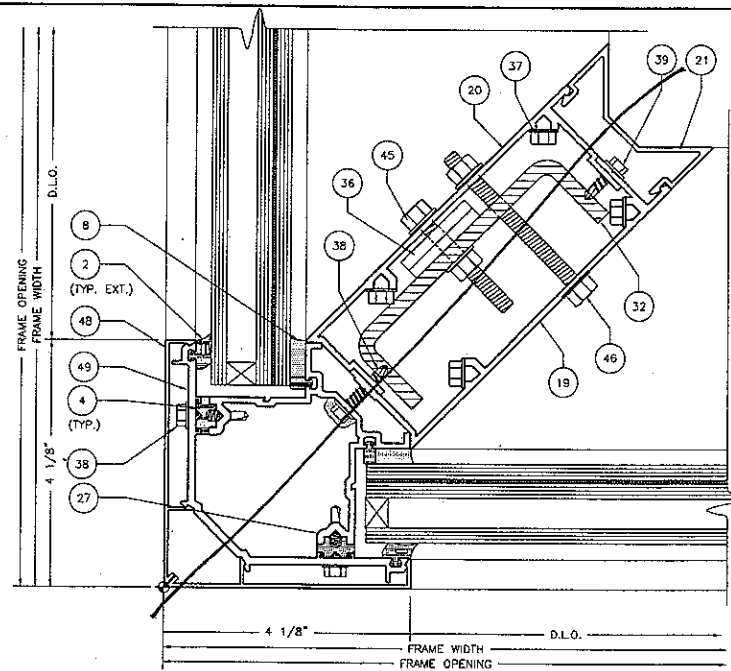


12 - DETAIL
1:2

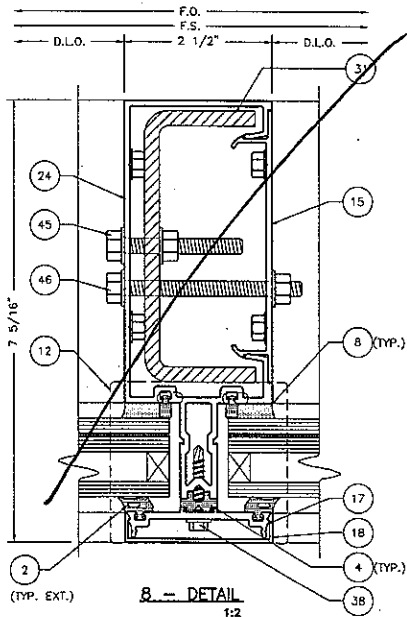

8 - DETAIL
1:2

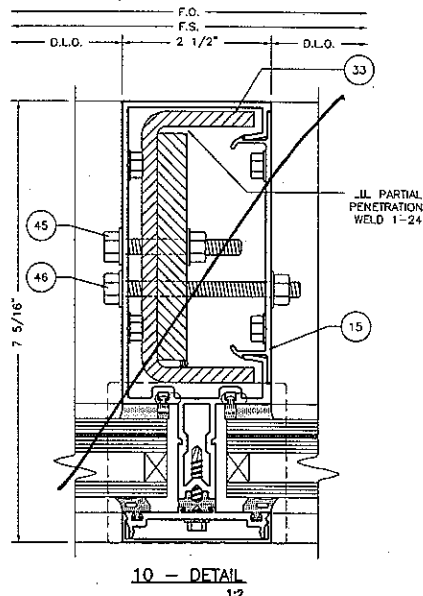

10 - DETAIL
1:2

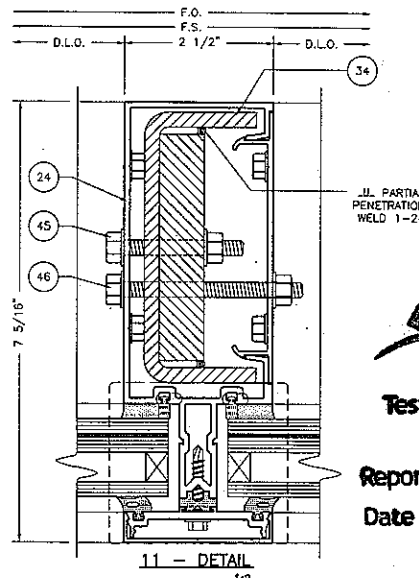

11 - DETAIL
1:2



Architectural Testing

Test sample complies with these details.
Deviations are noted.

Report# A2658.02-401-4A


Date 4/19/11 Tech SP

REV	DATE	BY	CHKD


Conal
Architectural Products
3010 BEAVERDALE TUSCALOOSA AL 35406
PHONE 800-773-7777 FAX 205-443-6330

TEST REPORT DRAWINGS
PW257 IMPACT-RESISTANT
CURTAIN WALL SYSTEM
FRAMING DETAILS

DATE	8/24/2010		
DRAWN	CHECKED	APPROVED	
MLL	DCW	DCW	
PROJECT NO.			
DRAWING NO.	PW257_01		
SHEET	9 OF 15		

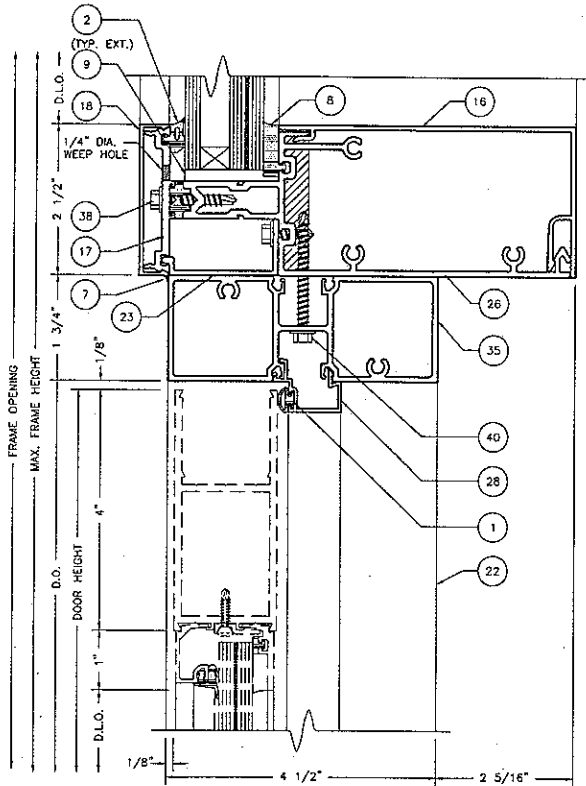

13 - DETAIL
1/2

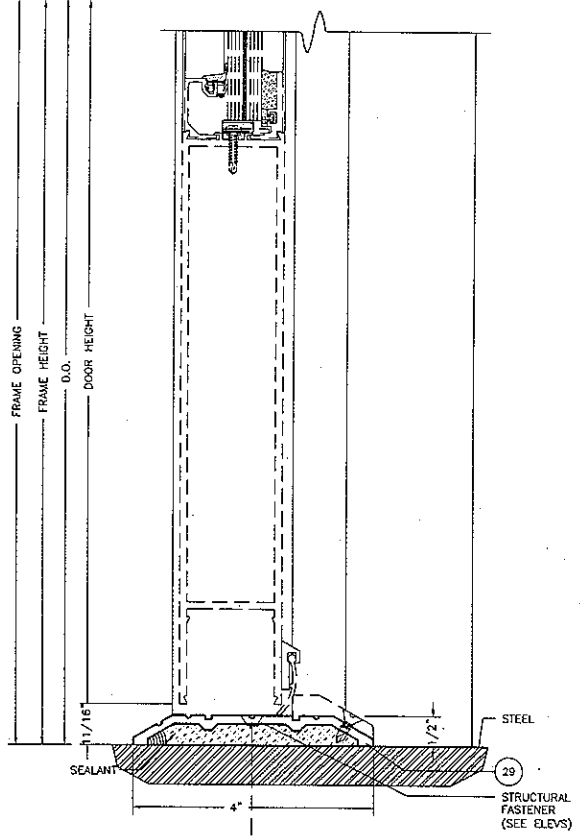

14 - DETAIL
1/2

Architectural Testing
 Test sample complies with these details.
 Deviations are noted.


Report# A2658.02-401-44
 Date 4/19/11 Tech SP

NO.	DATE	DESCRIPTION


Coral
 Architectural Products
 3010 REEFVIEW ROAD, TUSCALOOSA, AL 35468
 PHONE: 205-772-7737 FAX: 800-443-6261

TEST REPORT DRAWINGS
 PW257 IMPACT-RESISTANT
 CURTAIN WALL SYSTEM
 DOOR AND FRAMING DETAILS


DATE	8/24/2010	
DRAWN	CHECKED	APPROVED
MILL	DCW	DCW
PROJECT NO.		
DRAWING NO.		
PW257 01		
SHEET		
10 OF 15		

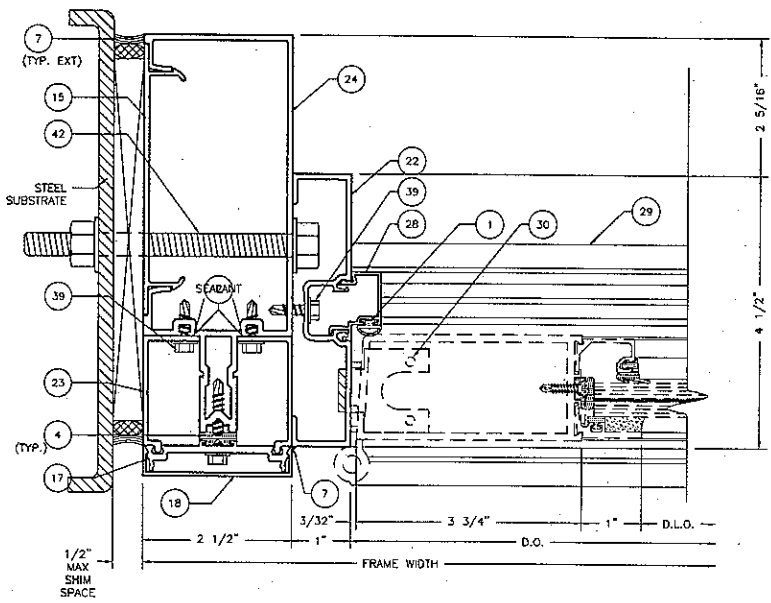

15 - DETAIL
1:2

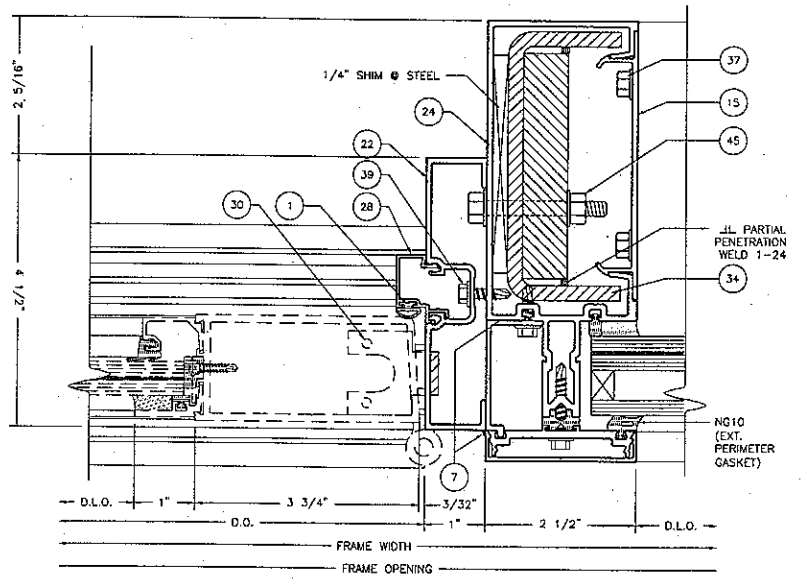

17 - DETAIL
1:2

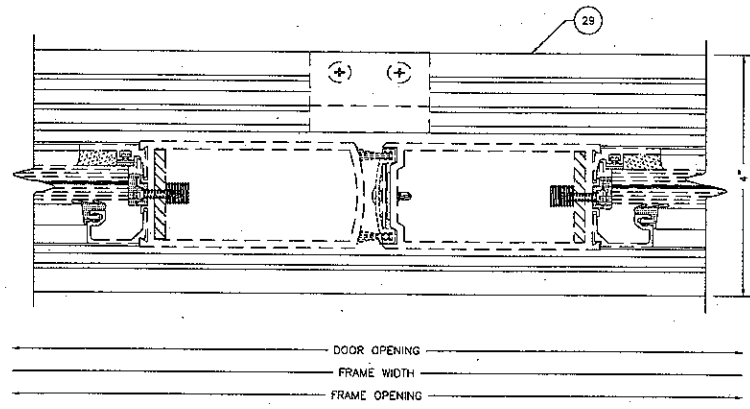

16 - DETAIL
1:2

Architectural Testing

Test sample complies with these details.
Deviations are noted.


Report# A2658-02-401-44
Date 4/19/11 Tech SP

REV.	BY	DATE	DESCRIPTION


Conal
Architectural Products
3010 BEECHER ROAD, TUCUMAN, CALIFORNIA 95306
PHONE: 909-772-7277 FAX: 909-448-6231

TEST REPORT DRAWINGS
PW257 IMPACT-RESISTANT
CURTAIN WALL SYSTEM
DOOR AND FRAMING DETAILS


DATE	8/24/2010	
DRAWN	CHECKED	APPROVED
ALL	DCW	DCW
PROJECT NO.		
DRAWING NO.	PW257_01	
SHEET	11 OF 15	

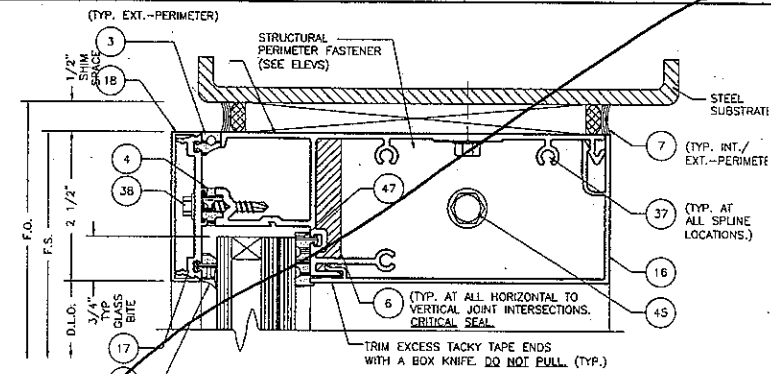


18 - DETAIL
1:2

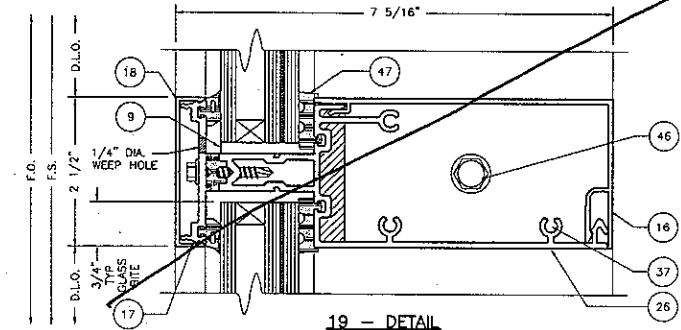


19 - DETAIL
1:2

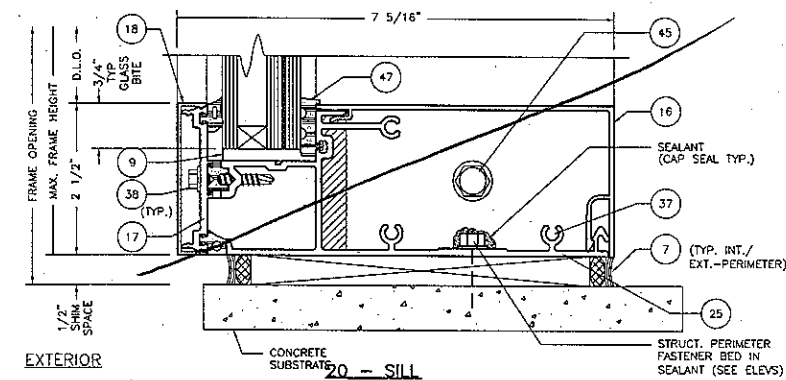

20 - SILL
1:2

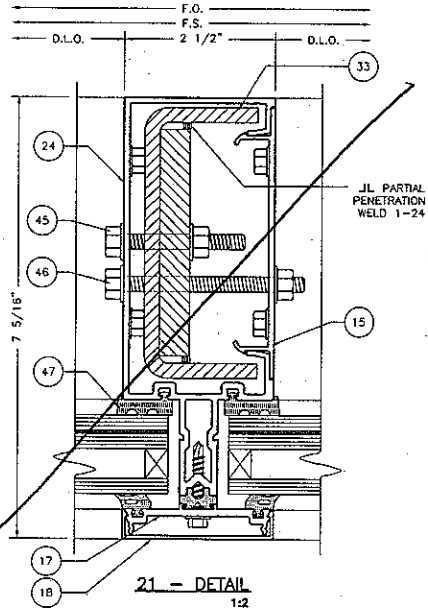

21 - DETAIL
1:2

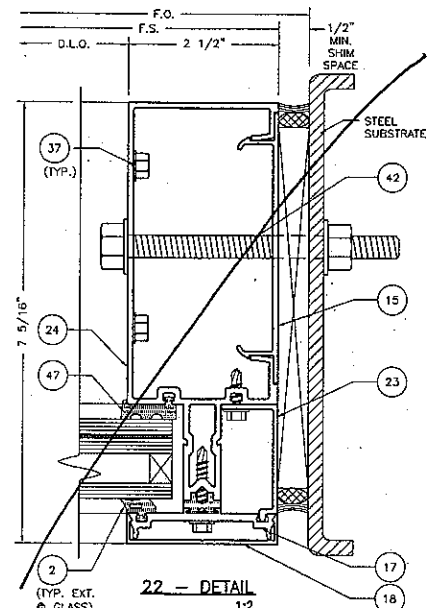

22 - DETAIL
1:2



Test sample complies with these details.
Deviations are noted.

Report# A2658.02-401-44
Date 4/19/11 Tech SP

DRAWING NO.			PW257 01		
SHEET			12 OF 15		
DATE	8/24/2010		DRAWN	CHECKED	APPROVED
			ALL	DCW	DCW
PROJECT NO.					
DESCRIPTION					
TEST REPORT DRAWINGS					
PW257 IMPACT-RESISTANT					
CURTAIN WALL SYSTEM					
FRAMING DETAILS					
Architectural Products 500 BEECHER RD. TUSCALOOSA, AL 35466 PHONE: 205-772-7737 FAX: 205-772-0021					

BILL OF MATERIALS

ITEM NO.	P/N	DESCRIPTION	DIMENSIONS	MATERIAL	MANUFACTURER	NOTES
1	NG5	BULB GASKET - DOORFRAME STOP	0.165 SPACE	EPDM	VARIES	
2	NG10	EXTERIOR GLAZING GASKET	0.250 SPACE	EPDM	VARIES	
3	NG11	EXTERIOR PERIMETER GASKET	0.300 SPACE	EPDM	VARIES	
4	NG12	PRESSURE BAR GASKET (ISOLATOR)	0.140 SPACE	EPDM	VARIES	
5	NG14	INTERIOR SPACER GASKET	0.250 SPACE	EPDM	VARIES	
6	SM5601	JOINT SEALANT TAPE	0.500 X 0.125 X VARIES	BUTYL	SCHNEE-MOOREHEAD	
7	795	SILICONE - PERIMETER SEALANT	FILL SPACE	SILICONE	DOW CORNING	USED @ PERIMETER
8	995	SILICONE - GLASS TO METAL	FILL SPACE	SILICONE	DOW CORNING	GLASS TO METAL AND INTERNAL
9	SB18	SETTING BLOCK @ SILL & HORIZONTAL	1.562 X 0.188 X 4.000	EPDM	VARIES	2 PER LITE
10	SP204	END DAM @ CAPTURED MULLION	1.287 X 1.787 X 0.745	EVA FOAM	CORAL INDUSTRIES, INC.	LOCATE 1 @ EACH END OF HORIZONTAL
11	SP208	BRIDGE DAM @ B.C. MULLION	3.125 X 1.662 X 0.745	EVA FOAM	CORAL INDUSTRIES, INC.	LOCATE 1 @ HORIZONTAL AND B.C. MULLION
12	SP211	MULLION CAP	3.000 X 2.691 X 0.048	6063-T6 ALUMINUM	CORAL INDUSTRIES, INC.	LOCATE @ TOP AND BOTTOM OF VERTICAL
13	2086	JACKSON 2086 PANEL	36.000 X 7.3425 X 3.000	ALUMINUM	JACKSON	
14	PW151	B.C. MULLION	2.500 X 3.000 X 0.094	6063-T6 ALUMINUM	CORAL INDUSTRIES, INC.	
15	PW202	OPEN BACK MULLION FILLER	0.681 X 4.484 X 0.094	6063-T6 ALUMINUM	CORAL INDUSTRIES, INC.	
16	PW203	HEAD/ SILL/ HORIZONTAL TRIM	2.500 X 4.980 X 0.078	6063-T6 ALUMINUM	CORAL INDUSTRIES, INC.	
17	PW204	PRESSURE BAR	2.443 X 0.433 X 0.125	6063-T6 ALUMINUM	CORAL INDUSTRIES, INC.	
18	PW205	FACE COVER	2.500 X 0.500 X 0.082	6063-T6 ALUMINUM	CORAL INDUSTRIES, INC.	
19	PW208	FEMALE HALF 90° CORNER	1.625 X 6.110 X 0.094	6063-T6 ALUMINUM	CORAL INDUSTRIES, INC.	
20	PW209	MALE HALF 90° CORNER	1.675 X 6.110 X 0.094	6063-T6 ALUMINUM	CORAL INDUSTRIES, INC.	
21	PW240	INTERIOR CORNER TRIM	2.500 X 1.200 X 0.078	6063-T6 ALUMINUM	CORAL INDUSTRIES, INC.	
22	PW214	SUB DOORFRAME	1.000 X 4.500 X 0.080	6063-T6 ALUMINUM	CORAL INDUSTRIES, INC.	
23	PW613	POCKET FILLER FOR PW650	0.937 X 1.943 X 0.078	6063-T6 ALUMINUM	CORAL INDUSTRIES, INC.	
24	PW650	VERTICAL MULLION	2.500 X 6.593 X 0.094	6063-T6 ALUMINUM	CORAL INDUSTRIES, INC.	
25	PW652	HEAD/SILL	2.390 X 6.495 X 0.094	6063-T6 ALUMINUM	CORAL INDUSTRIES, INC.	
26	PW655	INTERMEDIATE HORIZONTAL	2.390 X 6.495 X 0.094	6063-T6 ALUMINUM	CORAL INDUSTRIES, INC.	
27	PW636	GLAZING TEE - 90° CORNER	3.334 X 3.334 X 0.094	6063-T6 ALUMINUM	CORAL INDUSTRIES, INC.	
28	DS200	DOORFRAME STOP	0.882 X 1.149 X 0.050	6063-T6 ALUMINUM	CORAL INDUSTRIES, INC.	
29	TH4	THRESHOLD	0.500 X 4.000 X 0.125	6063-T6 ALUMINUM	CORAL INDUSTRIES, INC.	
30	TH403	THRESHOLD CLIP	1.390 X 1.516 X 1.909	STEEL	VARIES	

(CONTINUED ON SHEET 15)




Architectural Testing

Test sample complies with these details.
Deviations are noted.

Report# A2658.02-401-44
Date 4/19/11 Tech SP

NO.	REV.	DATE	DESCRIPTION


 Architectural Products
 3800 S. 102nd Ave., Suite 100
 Phoenix, AZ 85048
 Phone: 602.772.7777 Fax: 602.772.6001

TEST REPORT DRAWINGS
PW257 IMPACT-RESISTANT
CURTAIN WALL SYSTEM
BILL OF MATERIALS

DATE 8/24/2010

DRAWN ALL	CHECKED DCW	APPROVED DCW
--------------	----------------	-----------------

PROJECT NO.
DRAWING NO.
PW257_01
SHEET 13 OF 15

BILL OF MATERIALS

ITEM NO.	P/N	DESCRIPTION	DIMENSIONS	MATERIAL	MANUFACTURER	3NOTES
31	SR150	REINFORCEMENT CHANNEL	4.500 X 1.875 X 0.250	A36 STEEL	VARIES	STEEL REINFORCEMENT FOR (1) AND (2)
32	SR604	REINFORCEMENT CHANNEL	4.562 X 1.250 X 0.250	A36 STEEL	VARIES	STEEL REINFORCEMENT FOR (1) AND (2)
33		SR150 WITH REINFORCEMENT BAR	3.750 X 0.500	A36 STEEL	VARIES	STEEL REINFORCEMENT FOR (1) AND (2)
34		SR150 WITH REINFORCEMENT BAR	4" 3.750 X 0.750	A36 STEEL	VARIES	STEEL REINFORCEMENT FOR (1) AND (2)
35	FL207	DOOR HEADER	1.750 X 4.500 X 0.085	6063-T6 ALUMINUM	CORAL INDUSTRIES, INC.	
36	AS13	SQUARE NUT	1.475 X 1.475 X .180	STEEL	VARIES	
37	AS16	FASTENER	#14 X 1" HHSTS	STEEL	VARIES	TYP. SPLINE SCREW
38	AS32	FASTENER	#12 X 1-1/4" HWH #3 SELF DRILL	STEEL	VARIES	
39	AS25	FASTENER	#12 X 3/4" HWH SELF DRILL	STEEL	VARIES	
40	AS37	FASTENER	#12 X 2" HWH SELF DRILL	STEEL	VARIES	
41	FASTENER	PERIMETER ANCHOR TO STEEL SUBSTRATE	1/2"-13 X 2" BOLT WITH WASHER AND NUT	STEEL	VARIES	
42	FASTENER	PERIMETER ANCHOR TO STEEL SUBSTRATE	1/2"-13 X 4-1/2" BOLT WITH WASHER AND NUT	STEEL	VARIES	
43	FASTENER	PERIMETER ANCHOR TO CONCRETE SUBSTRATE	1/2"X3-1/2" MIN. EMBED WEDGE ANCHOR POWERS	STEEL	VARIES	
44	FASTENER	PERIMETER ANCHOR TO STEEL SUBSTRATE	#12 X 1-1/2" PFH SELF DRILL	STEEL	VARIES	
45	FASTENER	STEEL REINFORCEMENT ATTACHMENT	1/4-20 X 2" BOLT WITH WASHER AND NUT	STEEL	VARIES	
46	FASTENER	THROUGH BOLT	1/4-20 X 3" BOLT WITH WASHER AND NUT	STEEL	VARIES	USED @ HORIZONTALS
47	N616	DRY GLAZE INTERIOR SPACER GASKET	0.250 SPAGE	EPDM	VARIES	
48	PW658	CORNER FACE COVER	4.664 X .500 X 0.078	6063-T6 ALUM	CORAL INDUSTRIES, INC.	
49	EW654	CORNER PRESSURE BAR	3.954 X 3.954 X .125	6063 T6 ALUM	CORAL INDUSTRIES, INC.	
50	SP214	CORNER MULLION CAP	4.000 X 3.828 X 0.848	6063-T6 ALUM	CORAL INDUSTRIES, INC.	LOCATE @ TOP AND BOTTOM OF VERTICAL CORNER MULLION

GLAZING SCHEDULE


GLASS MARK	GLASS DESCRIPTION	MANUFACTURER	MAXIMUM D.L.O. SIZE (INCHES)	SQUARE FEET	MAXIMUM DESIGN PRESSURE (PSF)
IC	1-5/16" INSULATED -1/4" H.S. -1/2" AIR SPACER -1/4" H.S. DUPONT BUTCITE 090 PBV INTERLAYER N.O.A. #	DUPONT	57-1/2" X 96"	38.3	± 80"
IB	1-5/16" INSULATED -1/4" H.S. -1/2" AIR SPACER -1/4" H.S. -090 SAFLEX PVB INTERLAYER -1/4" H.S. N.O.A. #	SOLUTIA	45-1/2" X 96"	30.3	± 80"
ID	1-5/16" INSULATED -1/4" H.S. -1/2" AIR SPACER -1/4" H.S. -SENTRY GLASS PWS .090 -1/4" H.S.	DUPONT	57-1/2" X 96"	38.3	± 80



Test sample complies with these details
Deviations are noted.

Report# A2658.02-401-44
Date 4/19/11 Tech SP

DATE	05/24/2010	
DRAWN	CHECKED	APPROVED
MLL	DCW	DCW
PROJECT NO.		
DRAWING NO.		
PW257_01		
SHEET		
14 OF 15		





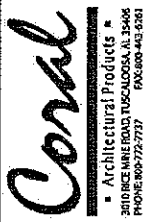


TEST REPORT DRAWINGS
PW257 IMPACT-RESISTANT
CURTAIN WALL SYSTEM
BILL OF MATERIALS AND GLAZING
SCHEDULE

DESCRIPTION

DATE

REV. BY

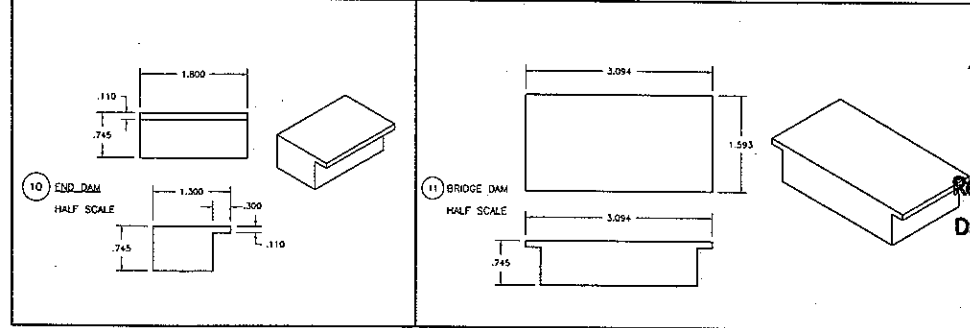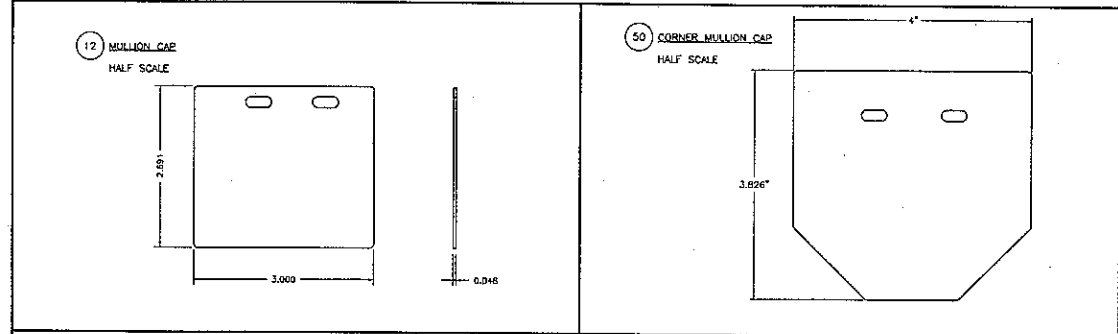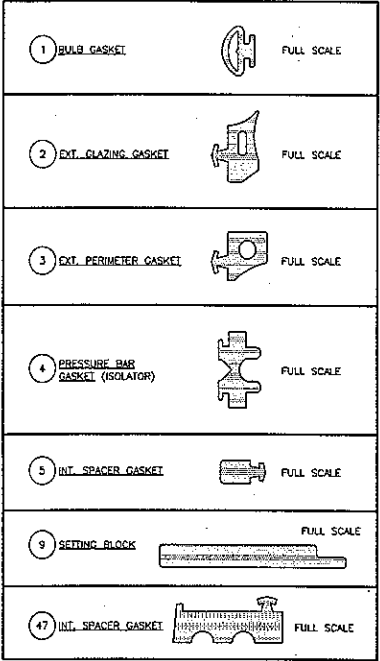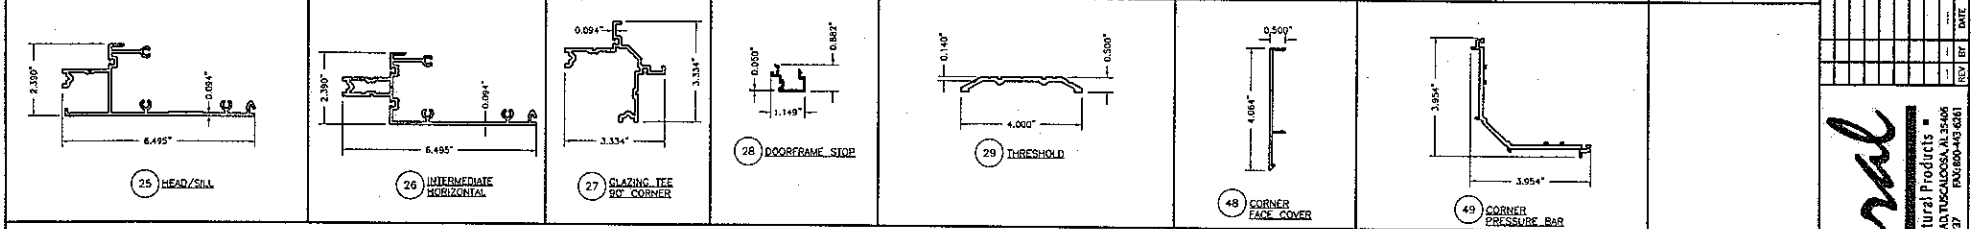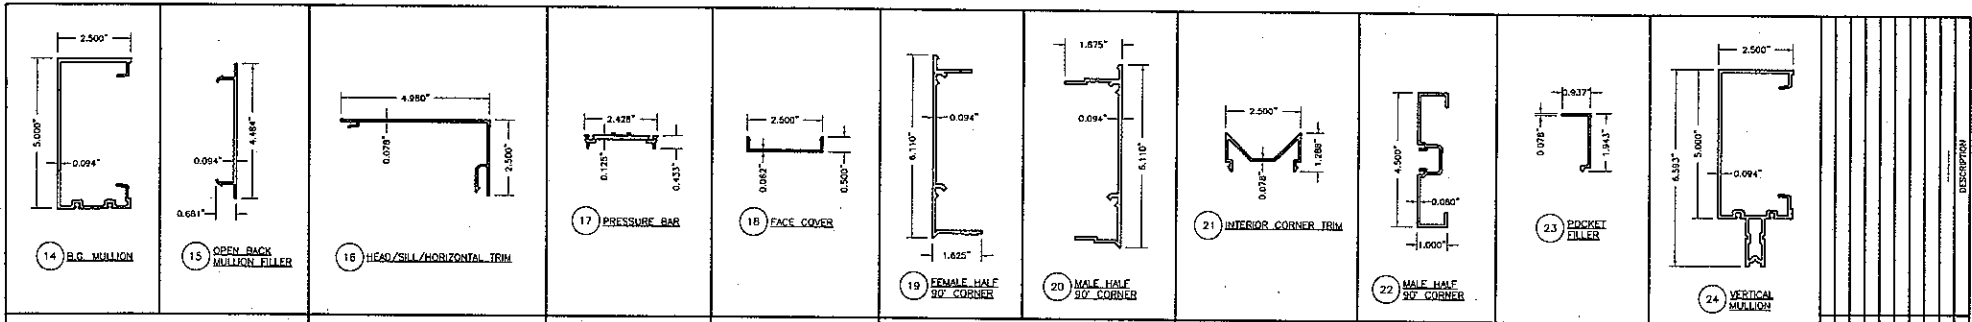

Architectural Testing

Test sample complies with these details.
Deviations are noted.

Report# A265B-02-401-44
Date 4/19/11 Tech SP

REV	BY	DATE	DESCRIPTION

Coral
Architectural Products
300 PEEBLES ROAD, FUSSELLS CREEK, VA 24646
PHONE: 800-772-7737 FAX: 800-443-6261

TEST REPORT DRAWINGS
PW257 IMPACT-RESISTANT
CURTAIN WALL SYSTEM
DIE DRAWINGS

DATE	8/24/2010	
BY	CHECKED	APPROVED
MLL	DCW	DCW
PROJECT NO.		
DRAWING NO.	PW257_01	
SHEET	15 OF 15	




Architectural Testing

Test Report No.: A2658.02-401-44
Report Date: 04/21/11
Test Record Retention End Date: 12/10/14

Appendix C Sketches

Sketch # 1

ELEVATION ES

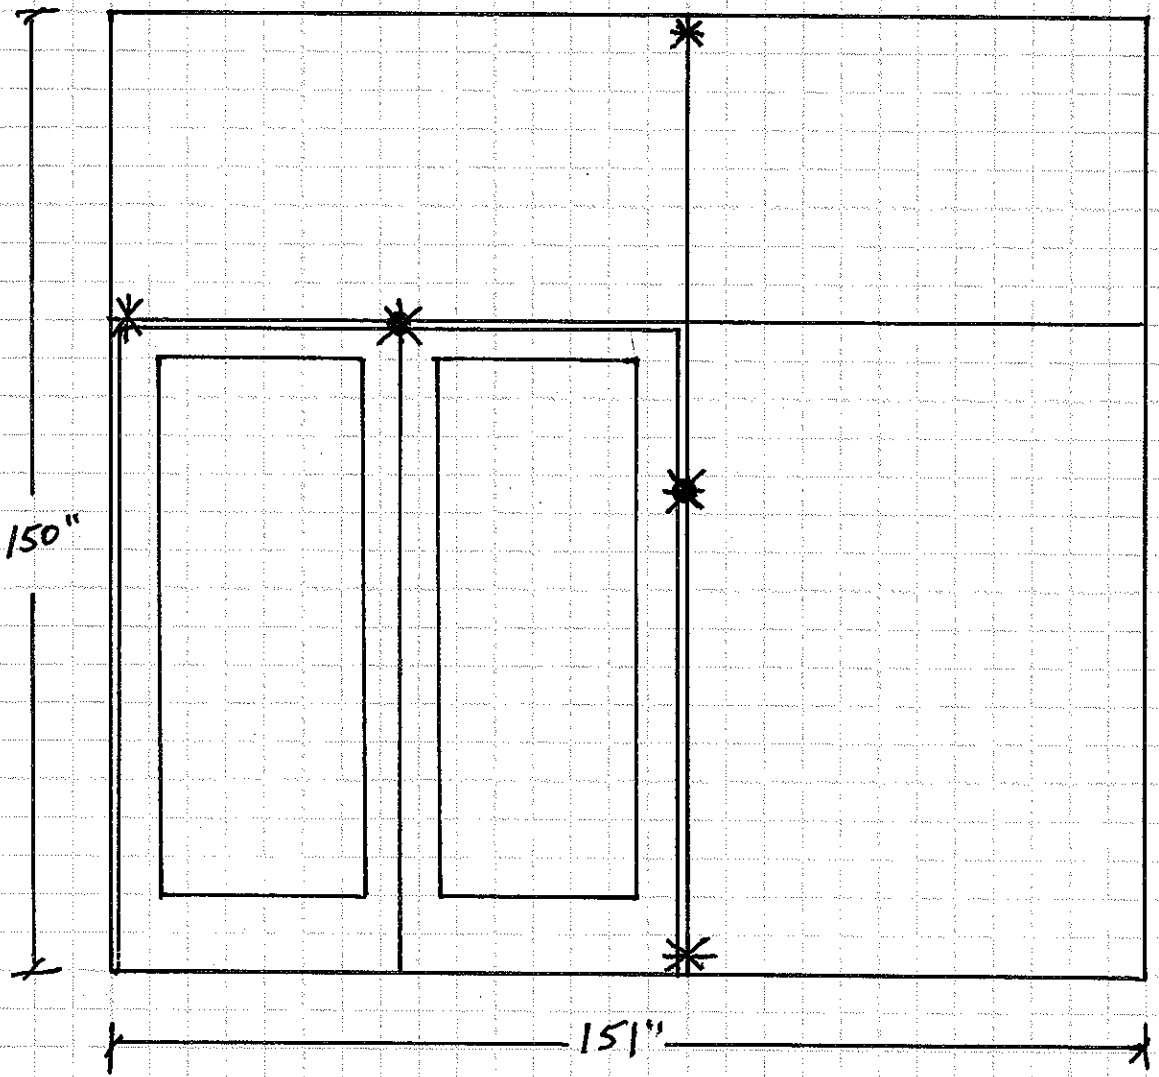

- * - INDICATOR LOCATIONS
- - IMPACT LOCATIONS